SPECIFICATION APPLIED

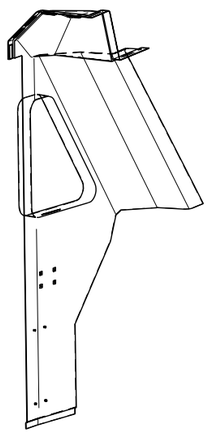

ISOMETRIC VIEW

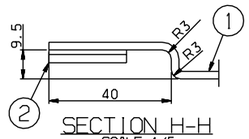

SECTION H-H
SCALE=1/5

SECTION G-G
SCALE=1/1

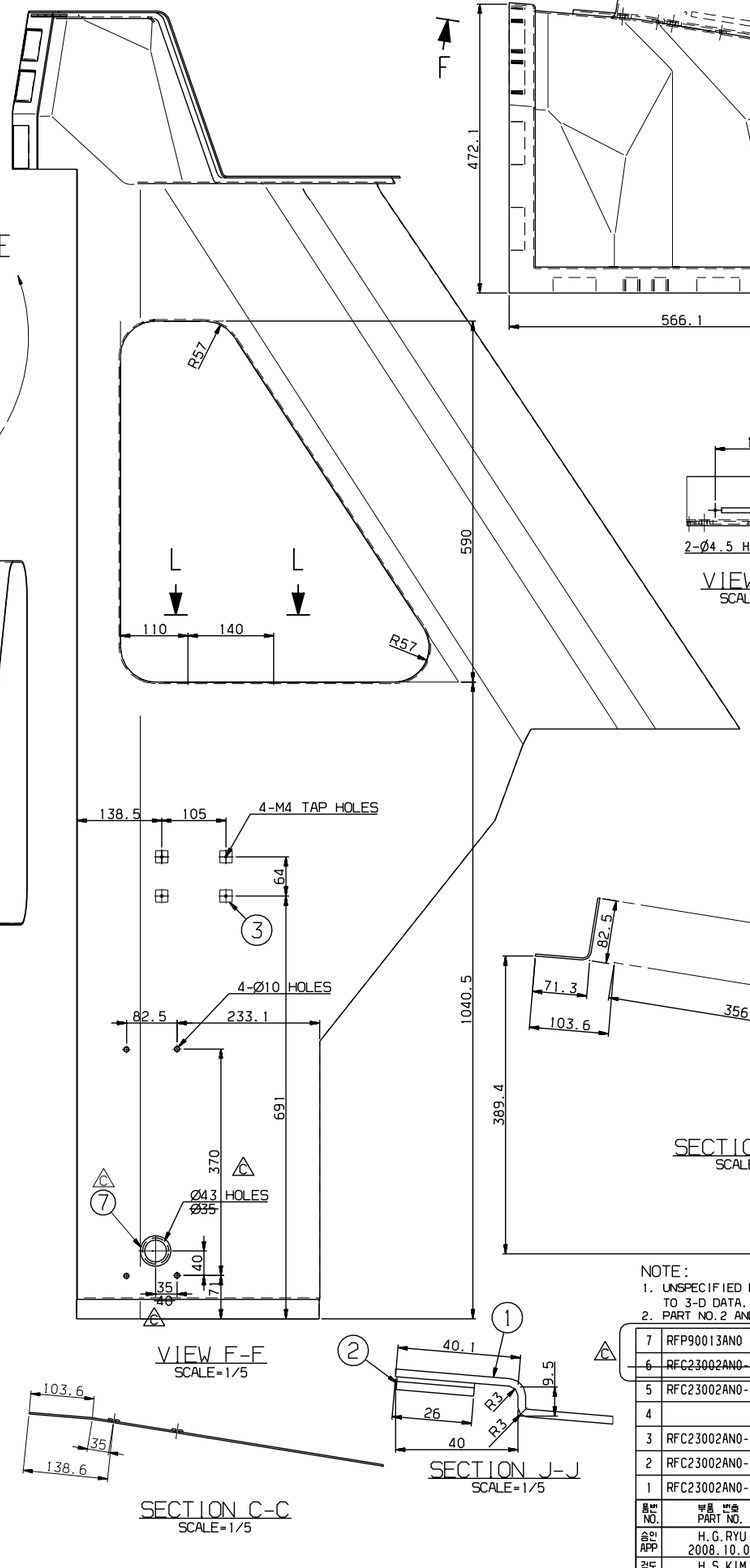

VIEW F-F
SCALE=1/5

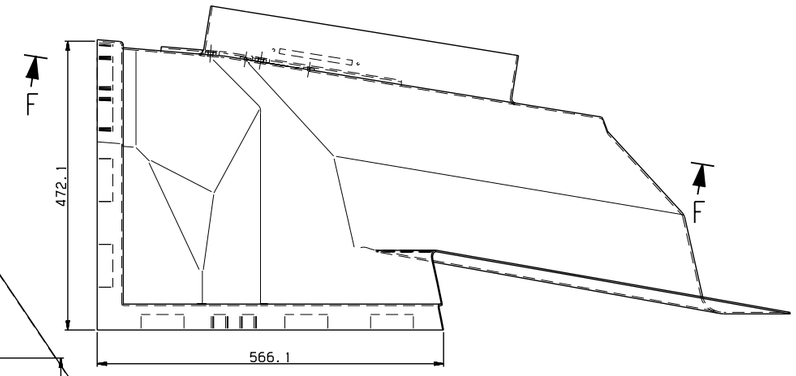

VIEW A
SCALE=1/4

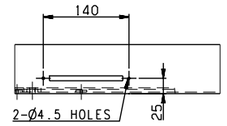

VIEW L-L
SCALE=1/5

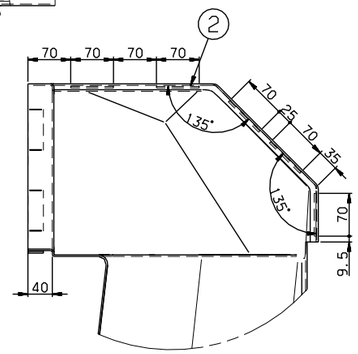

DETAIL E
SCALE=1/5

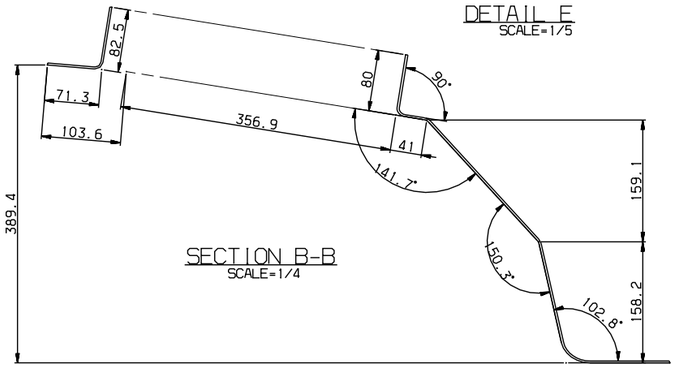

SECTION B-B
SCALE=1/4

SECTION D-D
SCALE=1/4

DETAIL K
SCALE=1/5

SECTION C-C
SCALE=1/5

SECTION J-J
SCALE=1/5

NOTE:
1. UNSPECIFIED DIMENSION SHALL BE ACCORDING TO 3-D DATA.
2. PART NO.2 AND 5 SHALL BE STRONGLY GLUED BY DP8005 OR EQUIVALENT.

품번 NO.	부품 번호 PART NO.	품명 DESCRIPTION	재질 MATERIAL	수량 Q'TY	검증 V.T	비고 REMARKS
7	RFP90013AN0	RUBBER, BUSH	ASSY	1		D3.3632
~~6~~	~~RFC23002AN0-006~~	~~BUSH~~	~~RUBBER~~	~~1~~		
5	RFC23002AN0-005	DUAL LOCK	ASSY	3		3M SJ3550, OR EQUIVALENT
4						
3	RFC23002AN0-003	TAP SEAT	SS400	4		T3.2X20X20
2	RFC23002AN0-002	DUAL LOCK	ASSY	10		3M SJ3550, OR EQUIVALENT
1	RFC23002AN0-001	PANEL	FRP	1		T2.5

승인 APP	H.G.RYU 2008.10.09	재질 MAT'L	ASSY	마 감 FINISH	
검도 CHK	H.S.KIM 2008.10.09	중량 G.W		TITLE	PANEL, FRONT (LEFT)
설계 DGN	J.I.LEE 2008.10.09	척도 SCALE	1/5	DRG. NO	RFC23002AN0 Ver. 00 Rev. -C
제도 DRG		SIZE	A1	MS	08-305101 FC-040

일반공차 GENERAL TOLERANCE			
부호	구분	CASTING (±)	
	~ 40	2	4
	~ 30	2	3
	~ 10	1	1.5
폐도	< 2	0.5	1
치수	~ 3150	-	7
	~ 1600	4	5
	~ 800	3	4
	~ 400	2	3
	~ 200	1.5	2
	~ 100	1	1.5
등급 GRADE		A	B
	구분	CASTING (±)	
	~ 20M	8	16
	~ 15M	7	12
	~ 12M	6	10
	~ 8M	5	8
	~ 4M	4	6
	~ 2M	3	4
	~ 1M	2	3
	~ 315	1	2
	~ 120	1	2
	~ 30	1	1
등급 GRADE		A	B
	구분	WELDING (±)	
	~ 20M	-	6.0
	~ 15M	-	5.0
	~ 12M	-	4.0
	~ 8M	-	3.0
	~ 4M	0.8	2.0
	~ 2M	0.5	1.2
	~ 1M	0.3	0.8
	~ 315	0.2	0.5
	~ 120	0.15	0.3
	~ 30	0.1	0.2
	1~6	0.05	0.1
등급 GRADE		A	B
	기계 가공품	MACHINING (±)	
		0.1	0.2

기호 MARK	일자 DATE	내역 DETAIL OF REVISION(E.C ZONE)	설변번호 E.C NO.	설계 DGN	검도 CHK	승인 APP
CX5	2010.11.12	DELETED #6 & ADDED #7. CHANGED SIZE OF HOLE FOR BUSH.	3D5101-U132	Y.I.KIM	K.B.PARK	J.H.PARK
BX3	2010.07.15	CORRECTING THE POSITION & SIZE of HOLES	3D5101-U117	J.I.LEE	H.S.KIM	H.G.RYU
AX3	2009.05.11	DELETE PART NO.4.	3D5101-U035	J.I.LEE	H.S.KIM	H.G.RYU

참조도면 REF. NO. FCP03620

본 도면은 당사 재산권에 해당하며 무단복사/배포 금지됨. PROPERTY OF ISSUING ENTITY. CANNOT BE DISTRIBUTED OR REPRODUCED WITHOUT AUTHORIZATION.

HYUNDAI Rotem 현대로템주식회사

CATIA