SPECIFICATION APPLIED

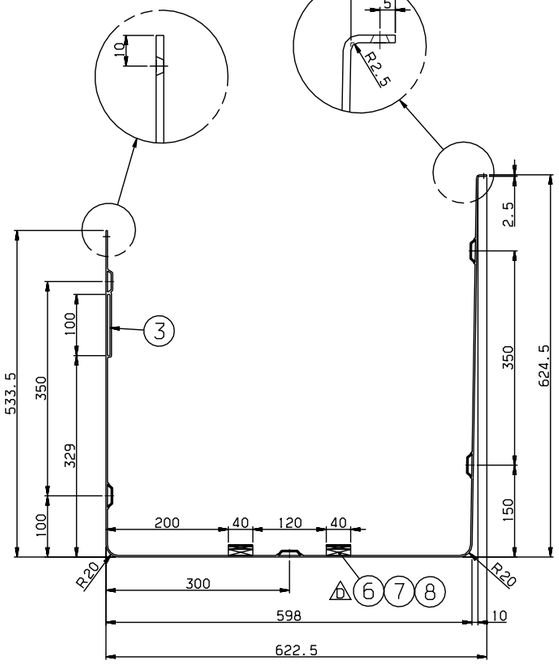

SECTION A-A
SCALE=1/5

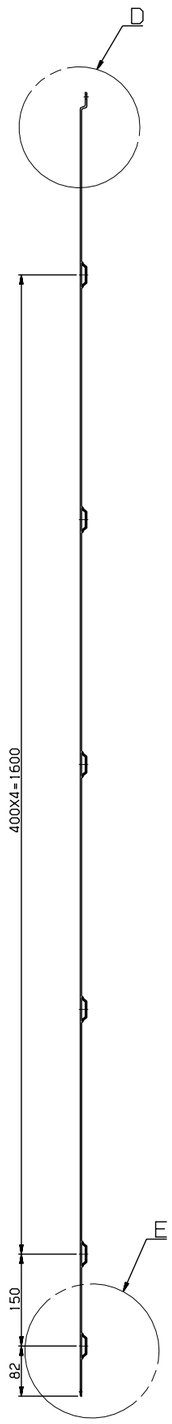

SECTION B-B
SCALE=1/5

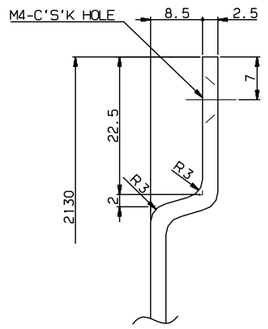

DETAIL D
SCALE=2/1

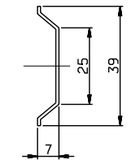

DETAIL #5
SCALE 1/1

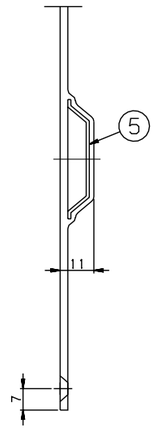

DETAIL E
SCALE=1/1

NOTE
1. AN INTERIOR PANEL'S COLOR(RAL 7047) AND SURFACE SHALL BE MANUFACTURED AFTER SAMPLE'S APPROVAL CUSTOMER

8	RFP50005AN0-008	PACKING	NEOPRENE RUBBER	4		T2.5X40X80
7	RFP50005AN0-007	PACKING	NEOPRENE RUBBER	4		T5X40X80
6	RFP50005AN0-006	PACKING	NEOPRENE RUBBER	4		T10X40X80
5	RFP50005AN0-005	STIFFENER	A1050P	1		T1, AR
4	RFP90013AN0	BUSH, RUBBER	ASSY	1		B1-1432
3	RFP50005AN0-003	SEAT, TAP	SUS304	1		T4X100X100
2	RFP50005AN0-002	SEAT, TAP	SUS304	2	⚠C	~~T3X280X30~~ ~~T3X240X30~~
1	RFP50005AN0-001	PANEL	FRP	1		T2.5

ITEM NO.	PART NO.	DESCRIPTION	MATERIAL	Q'TY	W.T	REMARKS

승인 APP	H.G.RYU 2008.11.17	재질 MAT'L	명 칭 TITLE: PANEL, FUNNEL, TYPE B(2/2)
검도 CHK	H.S.KIM 2008.11.17	중량 G.W	
설계 DGN	Y.D.KIM 2008.11.13	일반공차 MC / WD / CT: B / B / B	도면 번호 DRG. NO: RFP50005AN0 Ver. 00 Rev. -0
제도 DRG	S.H.SONG 2008.11.13	SIZE A1	SCALE 1/5 매수 SHEET 2 of 2
	참고용 REF. NO.		HYUNDAI Rotem 현대로템주식회사

기호 MARK	일자 DATE	변경내역 DETAIL OF REVISION(E.C ZONE)	설변번호 E.C NO.	설계 DGN	검도 CHK	승인 APP
DX3	2011.03.23	ADDED PART NO. ⌀6, ⌀7, ⌀8.	3D5101-U151	Y.T.KIM	K.B.PARK	J.H.PARK
CX2	2010.07.21	CHANGED THE DIMENSION.	3D5101-U119	Y.D.KIM	H.S.KIM	H.G.RYU
BX1	2009.07.15	CHANGED MATERIAL.	3D5101-U081	Y.D.KIM	H.S.KIM	H.G.RYU
AX9	2009.02.23	ADDED PART 4,5/CHANGED PART 3.DIM.,.NOTE	3D5101-U033	Y.D.KIM	H.S.KIM	H.G.RYU

일반공차 GENERAL TOLERANCE				
주물 CASTING				
	~ 40	2	4	
	~ 30	2	3	
	~ 10	1	1.5	
볼트 BOLT	< 1	0.5	1	
절곡 BENDING	~ 3150	-	7	
	~ 1600	4	5	
	~ 800	3	4	
	~ 400	2	3	
	~ 200	1.5	2	
	~ 100	1	1.5	
등급 GRADE		A	B	
주물, 수준용 CASTING (±)				
~ 20M	8	14	24	
~ 15M	7	12	21	
~ 12M	6	10	18	
~ 8M	5	8	14	
~ 4M	4	6	11	
~ 2M	3	4	8	
~ 1M	2	3	6	
~ 315	1	2	4	
~ 120	1	2	3	
~ 30	1	1	1	
등급 GRADE		A	B	C
절곡 가공용 WELDING (±)				
~ 20M	-	6.0	8.0	
~ 15M	-	5.0	7.0	
~ 12M	-	4.0	6.0	
~ 8M	-	3.0	5.0	
~ 4M	0.8	2.0	4.0	
~ 2M	0.5	1.2	3.0	
~ 1M	0.3	0.8	2.0	
~ 315	0.2	0.5	1.2	
~ 120	0.15	0.3	0.8	
~ 30	0.1	0.2	0.5	
3~5	0.05	0.1	0.2	
등급 GRADE		A	B	C
기계 가공용 MACHINING (±)				
주요사항은 별도공차를 적용한다 GENERAL TOLERANCE				

본 도면은 당사 재산권에 속하므로 무단복제/배포 금지됨. PROPERTY OF ISSUING ENTITY, CANNOT BE DISTRIBUTED OR REPRODUCED WITHOUT AUTHORIZATION.

3D5101 RFP- 난-PRJT 참조번호 CATIA