SPECIFICATION APPLIED

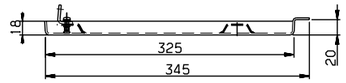

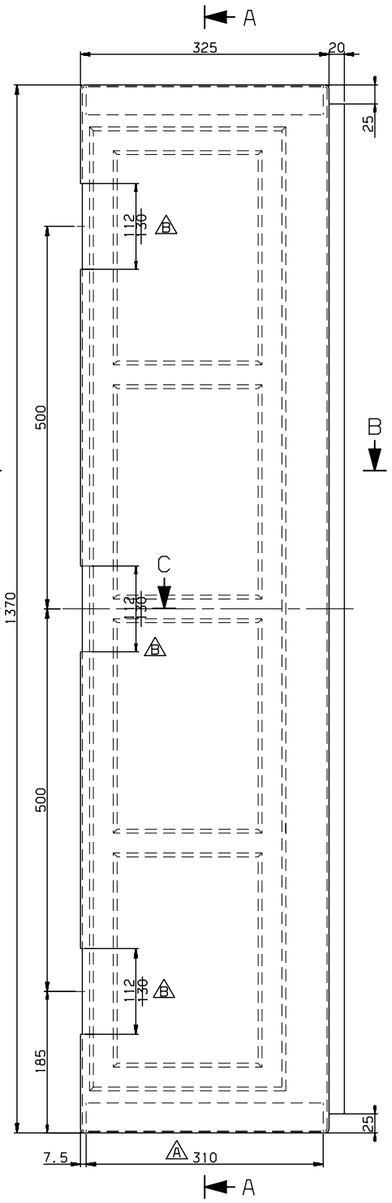

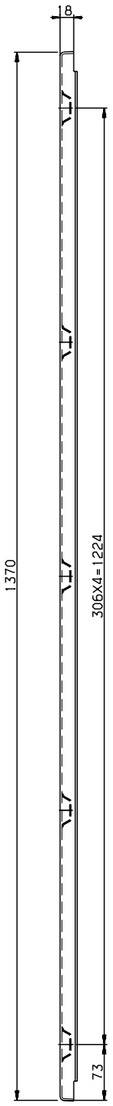

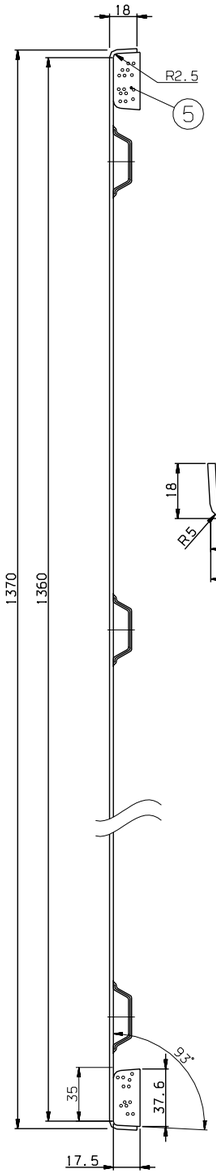

SECTION A-A
SCALE=1/2

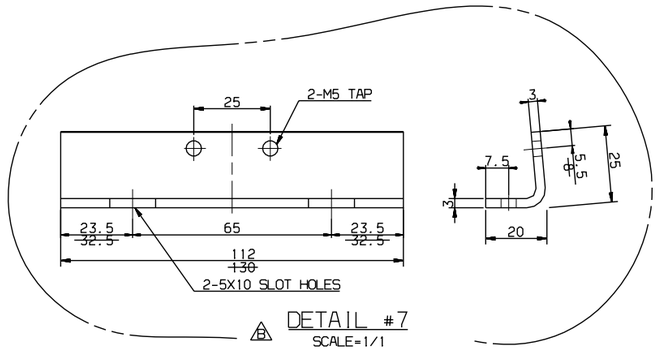

A DETAIL #7
SCALE=1/1

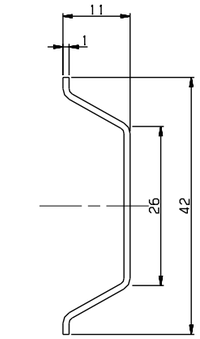

A DETAIL #9
SCALE=2/1

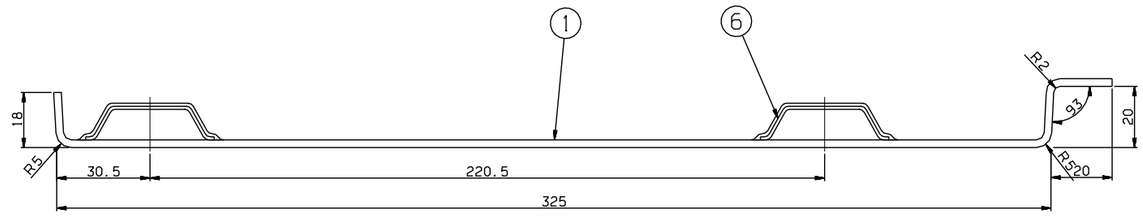

SECTION B-B
SCALE=1/1

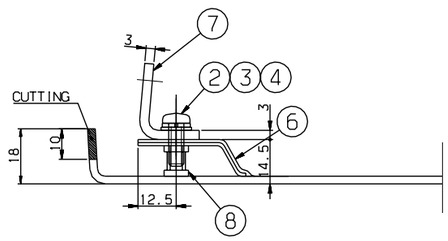

SECTION C-C
SCALE=1/1

NOTE
1. A SURFACE COLOR SHALL BE RAL7047.

8	RFP50012AN0-008	NUTSERT	SUS304	6		
7	RFP50012AN0-007	BRACKET, HINGE	SUS304	3		T3
6	RFP50012AN0-006	STIFFENER	~~A6063~~ A1050P	SET		T1
5	RFP50012AN0-005	PACKING	PU SPONGE	~~SET~~ 2		~~T14~~ T17.5X310
4	RS60807-008S	WASHER, PLAIN	SUS304	6		M5
3	RS60801-005S	WASHER, SPRING	SUS304	6		M5
2	RS60610-088S	SCREW	SUS304	6		M5X14L
1	RFP50012AN0-001	COVER	FRP	1		T2.5
품번 NO.	부품 번호 PART NO.	품명 DESCRIPTION	재질 MATERIAL	수량 Q'TY	중량 W.T	비고 REMARKS

승인 APP	H.G.RYU 2008.10.15	재질 MAT'L		명칭 TITLE	COVER, TYPE A
검도 CHK	H.S.KIM 2008.10.15	중량중 G.W			
설계 DGN	Y.D.KIM 2008.10.10	일반공차 MC / VD / CT		도면 번호 DRG. NO	RFP50012AN0 Ver. 00 Rev. -B
제도 DRG	S.H.SONG 2008.10.10	B / B / B		SCALE 1/4	매수 SHEET 1 of 1
	참고번호 REF. NO. FPP12143	SIZE A1		HYUNDAI Rotem 현대로템주식회사	

기호 MARK	일자 DATE	변경 내역 DETAIL OF REVISION(E.C ZONE)	설변번호 E.C NO.	설계 DGN	검도 CHK	승인 APP
BX4	2011.02.09	REVISED PART NO. #7.	3D5101-U144	Y.T.KIM	K.B.PARK	J.H.PARK
AX3	2009.01.13	ADDED NO.9	3D5101-U019	Y.D.KIM	H.S.KIM	H.G.RYU

일반공차 GENERAL TOLERANCE				
치수 구분 DIMENSION				
~ 40	2	4		
~ 30	2	3		
~ 10	1	1.5		
< 3	0.5	1		
절삭 가공 CUTTING	~3150	-	7	
	~1600	4	5	
	~800	3	4	
	~400	2	3	
	~200	1.5	2	
	~100	1	1.5	
등급 GRADE		A	B	
주조, 주물 CASTING (±)				
~20M	B	14	24	
~15M	7	12	21	
~12M	6	10	18	
~8M	5	8	14	
~4M	4	6	11	
~2M	3	4	8	
~1M	2	3	6	
~315	1	2	4	
~120	1	2	3	
~30	1	1	1	
등급 GRADE		A	B	C
용접 구조물 WELDING (±)				
~20M	-	6.0	8.0	
~15M	-	5.0	7.0	
~12M	-	4.0	6.0	
~8M	-	3.0	5.0	
~4M	0.8	2.0	4.0	
~2M	0.5	1.2	2.0	
~1M	0.3	0.8	2.0	
~315	0.2	0.5	1.2	
~120	0.15	0.3	0.8	
~30	0.1	0.2	0.5	
3~6	0.05	0.1	0.2	
등급 GRADE		A	B	C
기계 가공품 MACHINING (±)				
일반공차은 상호교환 GENERAL TOLERANCE				

본 도면은 당사 재산이므로 무단복사/배포 금지. PROPERTY OF ISSUING ENTITY. CANNOT BE DISTRIBUTED OR REPRODUCED WITHOUT AUTHORIZATION.

3D5101 RFP- 난-PRJT 상위번호 CATIA